


VACATION AND REFILING OF
WESTCREEK LAKES SUBDIVISION NO.2

DOUGLAS COUNTY
COLORADO

Karcich and Weber, Inc.
Engineers
COLORADO SPRINGS, COLORADO

"having heretofore submitted and presented "WESTERRED LAKES SUBDIVISION NO. 2", Douglas County, Colorado, containing 1,000± acres, located on the 60th Street, Lakewood, Colorado, as represented No. 31810 with the Clerk and Recorder of Douglas County, State of Colorado, now being withdrawn or adjusting and relocating certain lot lines, the result of which will affect all other lines and several boundaries given herein, declare, and by these presents do Vacate, all lots, lines, interests and rights, including boundaries, roads, drives, lanes and easements contained in the heretofore described "West in Lakewood" lots in Subdivision No. 2.

ATTORNEY

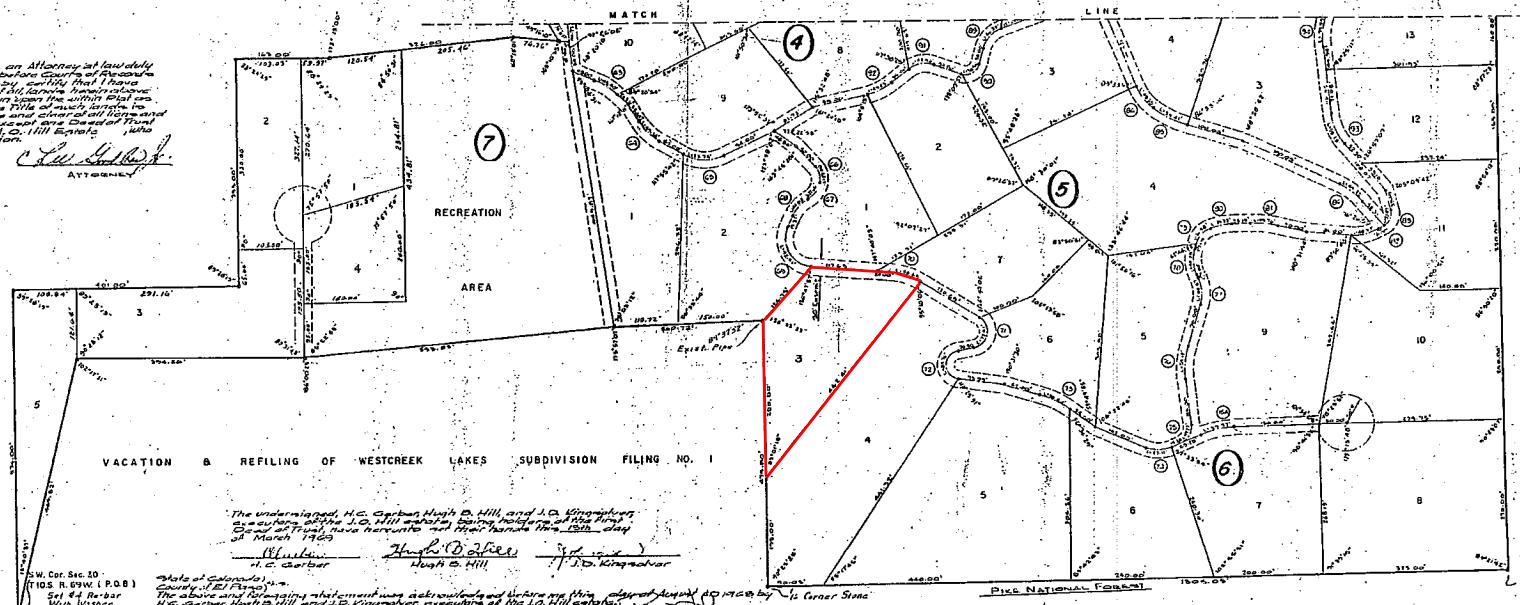

Westcreek Development Co.

Personal References

ILING OF WEST CREEK LAKES SUBDIVISION NO. 2 is approved by the Board of County
Douglas County, acting as the Planning Commission of Douglas County, Colorado,
of APRIL 1, A.D. 1969.

Henry F. Kunkel
Douglas County Planning Commission, Chairman,
Ex-officio Board of County Commissioners, Douglas County

$\sigma = \pi/4$ Period with neither travel for all boundary corners

Water service will be provided by the Developer for lots of one acre or less.

STATE OF COLORADO)
COUNTY OF El Paso)
The above and foregoing
the Wastecreek Develop-
ment Plan, Form 1516

My Commission expires. Witness my hand and official seal

My Commission expired.
Witness my hand and official seal

This 1st day of January AD 1962
H. Ruenheck, President and Donald C.

My Commission expired.
Witness my hand and official seal

The undersigned Registered Engineer am

accompanying Plan was drawn under the
of land and the Subdivision thereof as

lines, water lines, ditches, or utilities, or
any other roads and paths.

KNOWLEDGE-SEEING DANCE.

—
—
Digitized by srujanika@gmail.com

I hereby certify that this instrument was filed for record in my office at 8:00 o'clock A.M.
the day of , AD 1967, and is duly recorded in Plat Book at Page .